

TG13.1 – Roof Park Landscaping and Irrigation


Questions are numbered in the order received. Numbers missing in the sequence either have been answered in a previous response set or will be answered in a future set.

Question No.	Submission Date	Drawing No.	Document/ Spec. No.	Question	Response
TG13.1-060	4/16/2015	00 08 06 PLA, L1-4602-4607 and L1-6632-6637		Please confirm which unions are claiming the drainage (as shown on the piping sheets L1-4602 to L1-4607) and the irrigation (as shown on irrigation sheets L1-6632 to L1-6637).	Local 38 Plumbing Union claims landscape irrigation within building limits, including drainage piping; however, perforated drainage piping may be an exception. Contact Bill Blackwell of Local 38 at 415-626-2000 for further clarification on Union jurisdiction.
TG13.1-064	4/22/2015	SKLA 376, RFI 2173	TG13.1 Pre-Bid Presentation Slide 14	We are requesting clarification if there will be a formal Detail issued for the attached Roof Park Utility Trench Diagram that was shown on Page 14 of the Pre-Bid Meeting Presentation.	The sketch provided suggests an option for the general arrangement of conduit along this corridor, as a guideline for installation. A coordinated shop drawing detailing Rooftop Park Utility Trench specifications shall be provided by the TG13.1 Trade Subcontractor. No formal drawing will be issued.
TG13.1-065	4/22/2015	32 34 10, Part 2 Products; 2.2.A., L1-5602 through L1-5607, Details 1 & 2/L1-7690		We understand that we are responsible for determining the amount of Geo-Synthetic Fill required. We are requesting the Architect's estimated quantity of the Geo-Synthetic Fill for comparison use only.	The Architect's estimated quantity will not be provided. Bidder should refer to the contract drawings to determine estimated quantities.
TG13.1-066	4/22/2015	32 91 00, Part 2 - Products, 2.4, L-0005, L1-5622 through L1-5627, Details 1 through 9 on L1-9660		We understand that we are responsible for determining the amount of Soil Mixes required. We are requesting the Architect's estimated quantities of the various Soil Mixes as listed in the "General Park Level Soils Plans" Legend on Sheet L-0005, and as shown on the Park Level Soils Plans Phase 1 Sheets L1-5622 through L1-5627 for comparison use only.	The Architect's estimated quantities will not be provided Bidder should refer to the contract drawings to determine estimated quantities.

TG13.1-067	4/22/2015	03 45 00, Part 2 - Products; 2.3.B., L1-7664, L1-3602 through L1-3607, L1-4602 through L1-4607		We are requesting the Top of Lid Elevations for all the Precast Concrete Roof Drain Enclosures at Planting Areas that are shown on Sheets L1-4602 through L1-4607, in order to determine the overall heights required. Currently the only Top of Lid Elevations provided are those shown in Detail 1-Bamboo Grove Subslab Enlargement Plan on Sheet L1-2646.	The top of lid elevation of the precast concrete roof drain is 1'-6" below finish grade. Please refer to attached SKLA 401.0 for clarification.
TG13.1-068	4/22/2015	2/L1-9665, L1-5622 through L1-5627		We are requesting clarification as to the limits of where the ¾" Plywood and ½" Protection Board is to be installed around the 3" Waterproofing Assembly at the Beams. Are they to be installed only at the Beams within the Soil Mix Areas as shown on the Park Level Soils Plans Sheets L1-5622 through L1-5627?	Yes. The ¾" plywood and 1/2" protection board shall be installed only at the beams within the soil mix area, as shown on the park level soils plan. Refer to L1-5622 to L1-5627.
TG13.1-069	4/22/2015	33 41 19, Part 2 - Products; 2.2.J, 1/L1-9650, L1-4604		On this Sheet there are 3 each Catch Basin with Area Drain Grate – 9" diameter shown to be installed in the Bus Fountain Precast Concrete Modules. 1 is between Grid Lines 13 & 14 and B & C; 1 is between Grid Lines 14 & 15 and B & C; 1 is between Grid Lines 18 & 19 and B & C. However, per the Park Level Details Precast Concrete shown on Sheets L1-7655 through L1-7658, there is only a Knock for a Drain Body – 4" Diameter. Please clarify if the Catch Basin in the Precast Concrete Modules are to be 9" diameter or 4" Diameter.	Please refer to attached SKLA 402.0 through 402.3 for clarification. All drains in basin are 4".
TG13.1-070	4/22/2015	33 41 19, Part 2 - Products; 2.2.P., 3/L1-9650, L1-3603, L1-4603		On Sheet L1-3603 there are 3 each Area Drain in Planting – 8" diameter shown to be installed at the following Grid Lines: 1 between Grid Lines 7 & 8 and Grid Lines C.3 & D with a Rim Elevation 86.40; 1 between Grid Lines 6 & 7 and Grid Lines D.4 & D.8 with a Rim Elevation 86.30; and 1 between Grid Lines 6 & 7 and Grid Lines E.6 & F with a Rim Elevation 86.30. They are along the base of the Mound. However, these Area Drains are not shown on Plan Sheet L1-4603 Park Level Zone 03 Piping Plan Phase 1. Please clarify if these Area Drains are to be installed.	The area drains were added to the piping plan. Refer to SKLA 402.0 enclosed in the response to QBD TG13.1-069.

TG13.1-071	4/22/2015	33 41 19, Part 2 - Products; 2.2.P., 3/L1- 9650, L1-3605, L1-4605		On Sheet L1-3605 there is an Area Drain in Planting – 8" diameter shown to be installed between Grid Lines 23 & 24 and Grid Lines F & F.7 with a Rim Elevation 86.16. In addition this Area Drain is shown to be installed on Top of the Roof Drain Enclosure in the Bamboo Basin at the same Grid Lines as above on Sheet L1-4605. Please clarify if this Area Drain is to be installed at the location as shown.	The area drain was deleted. Refer to SKLA 404 attached for clarification.
TG13.1-072	4/22/2015	33 41 19, Part 2 - Products; 2.2.K., 4/L1- 9651, L1-3606, L1-4606		On Sheet L1-3606 there is an Area Drain in Paving shown to be installed in the lower Stair landing area between Grid Lines 30 & 31 and Grid Lines E.6 & F with a Rim Elevation 83.50. However on Sheet L1-4606 the invert Elevation for this same Area Drain between Grid Lines 30 & 31 and E6. & F is shown to be 84.09. Please clarify the Rim and Invert Elevations.	The area drain rim elevation in the lower stair landing area is 83.50 as shown on sheet L1-3606. The invert elevation for the area drain was omitted. Refer to the responses to QBD TG13.1-025 and -026 for clarification.
TG13.1-074	4/22/2015	12 93 00, Part 2 Products, 2.3.A & B, Details 1 through 6 on L1- 9630, Details 1 through 6 on L1- 9631		Please find attached, for the owner's review and comments, a letter from Studio 431/ landscapeforms regarding the usage of Black Locust Lumber with Site Furnishings, as is specified on this Project. They are expressing their concerns regarding the Weatherability and Long-Term Aesthetics and have included images of typical results of weathered Black Locust when used in such instances. Currently they have provided a quote using FCS IPE Lumber for the Wood Slat Bench and Wood Slat Chairs. Please advise if this will be an acceptable alternative to the Black Locust Lumber.	Please provide bid based on material indicated in Contract Documents. Proposed alternate is not acceptable as it is in conflict with TJPA's recommended guideline: TROPICAL HARDWOOD AND VIRGIN REDWOOD BAN Pursuant to Section 804(b) of the San Francisco Code, the TJPA urges contractors not to import, purchase, obtain, or use for any purpose, any tropical hardwood product, virgin redwood or virgin redwood wood product.
TG13.1-075	4/22/2015	L1-9632 Details 1 through 4	L1-9632 Details 1 through 4	In Item iii. Site Furniture it states "not limited to the following, i.e., Benches, Bollards, Fountains and Pylons; this Trade Subcontractor shall install these items near the completion of roof park and coordinate with WOJV." We are requesting clarification if we are to install the Bollards, Fountains and Pylons since according to Exhibit A Item 3. Base Bid Scope; Roof Park Site Furnishings; Items 1 and 2, these items are not included in Trade Package TG13.1, only the Wood Slat Benches and Chairs, and the Café Chairs and Tables.	The TG13.1 Trade Subcontractor shall furnish and install footings for the utility bollard and drinking fountains as stated in the Exhibit A, IV. Scope of the Package and Bid Item Information, 3. Base Bid Item Scope. Utility bollard and drinking fountain embeds shall be provided by others for the TG13.1 Trade Subcontractor to place in their respective footings. Pylons are not in the TG13.1 Trade Subcontractor's scope of work.

TG13.1-076	4/22/2015	04 22 00, L1-7610 Detail 1 - 4, L1-7612 Detail 1 - 2, L1-2622 through L1-2627		We are requesting a Plan which shows the Top and Bottom Elevations for all the CMU Support Walls, as shown on the Park Level Subslab Plan Phase 1 Sheets L1-2622 through L1-2627.	The top of CMU wall footings can be found on the Architectural Protection Slab Plans (A1-2912 thru A1-2917). The bottom of the footings can be derived from the slopes provided on these plans.
TG13.1-077	4/22/2015	L1-7630		We are requesting clarification as to which Trade Subcontractor is responsible for installing the Glass Paving at Seismic Joint B.	The Glass Paving at Seismic Joint B is integral to the glass floor system and shall be installed by the TG08.11R Trade Subcontractor.

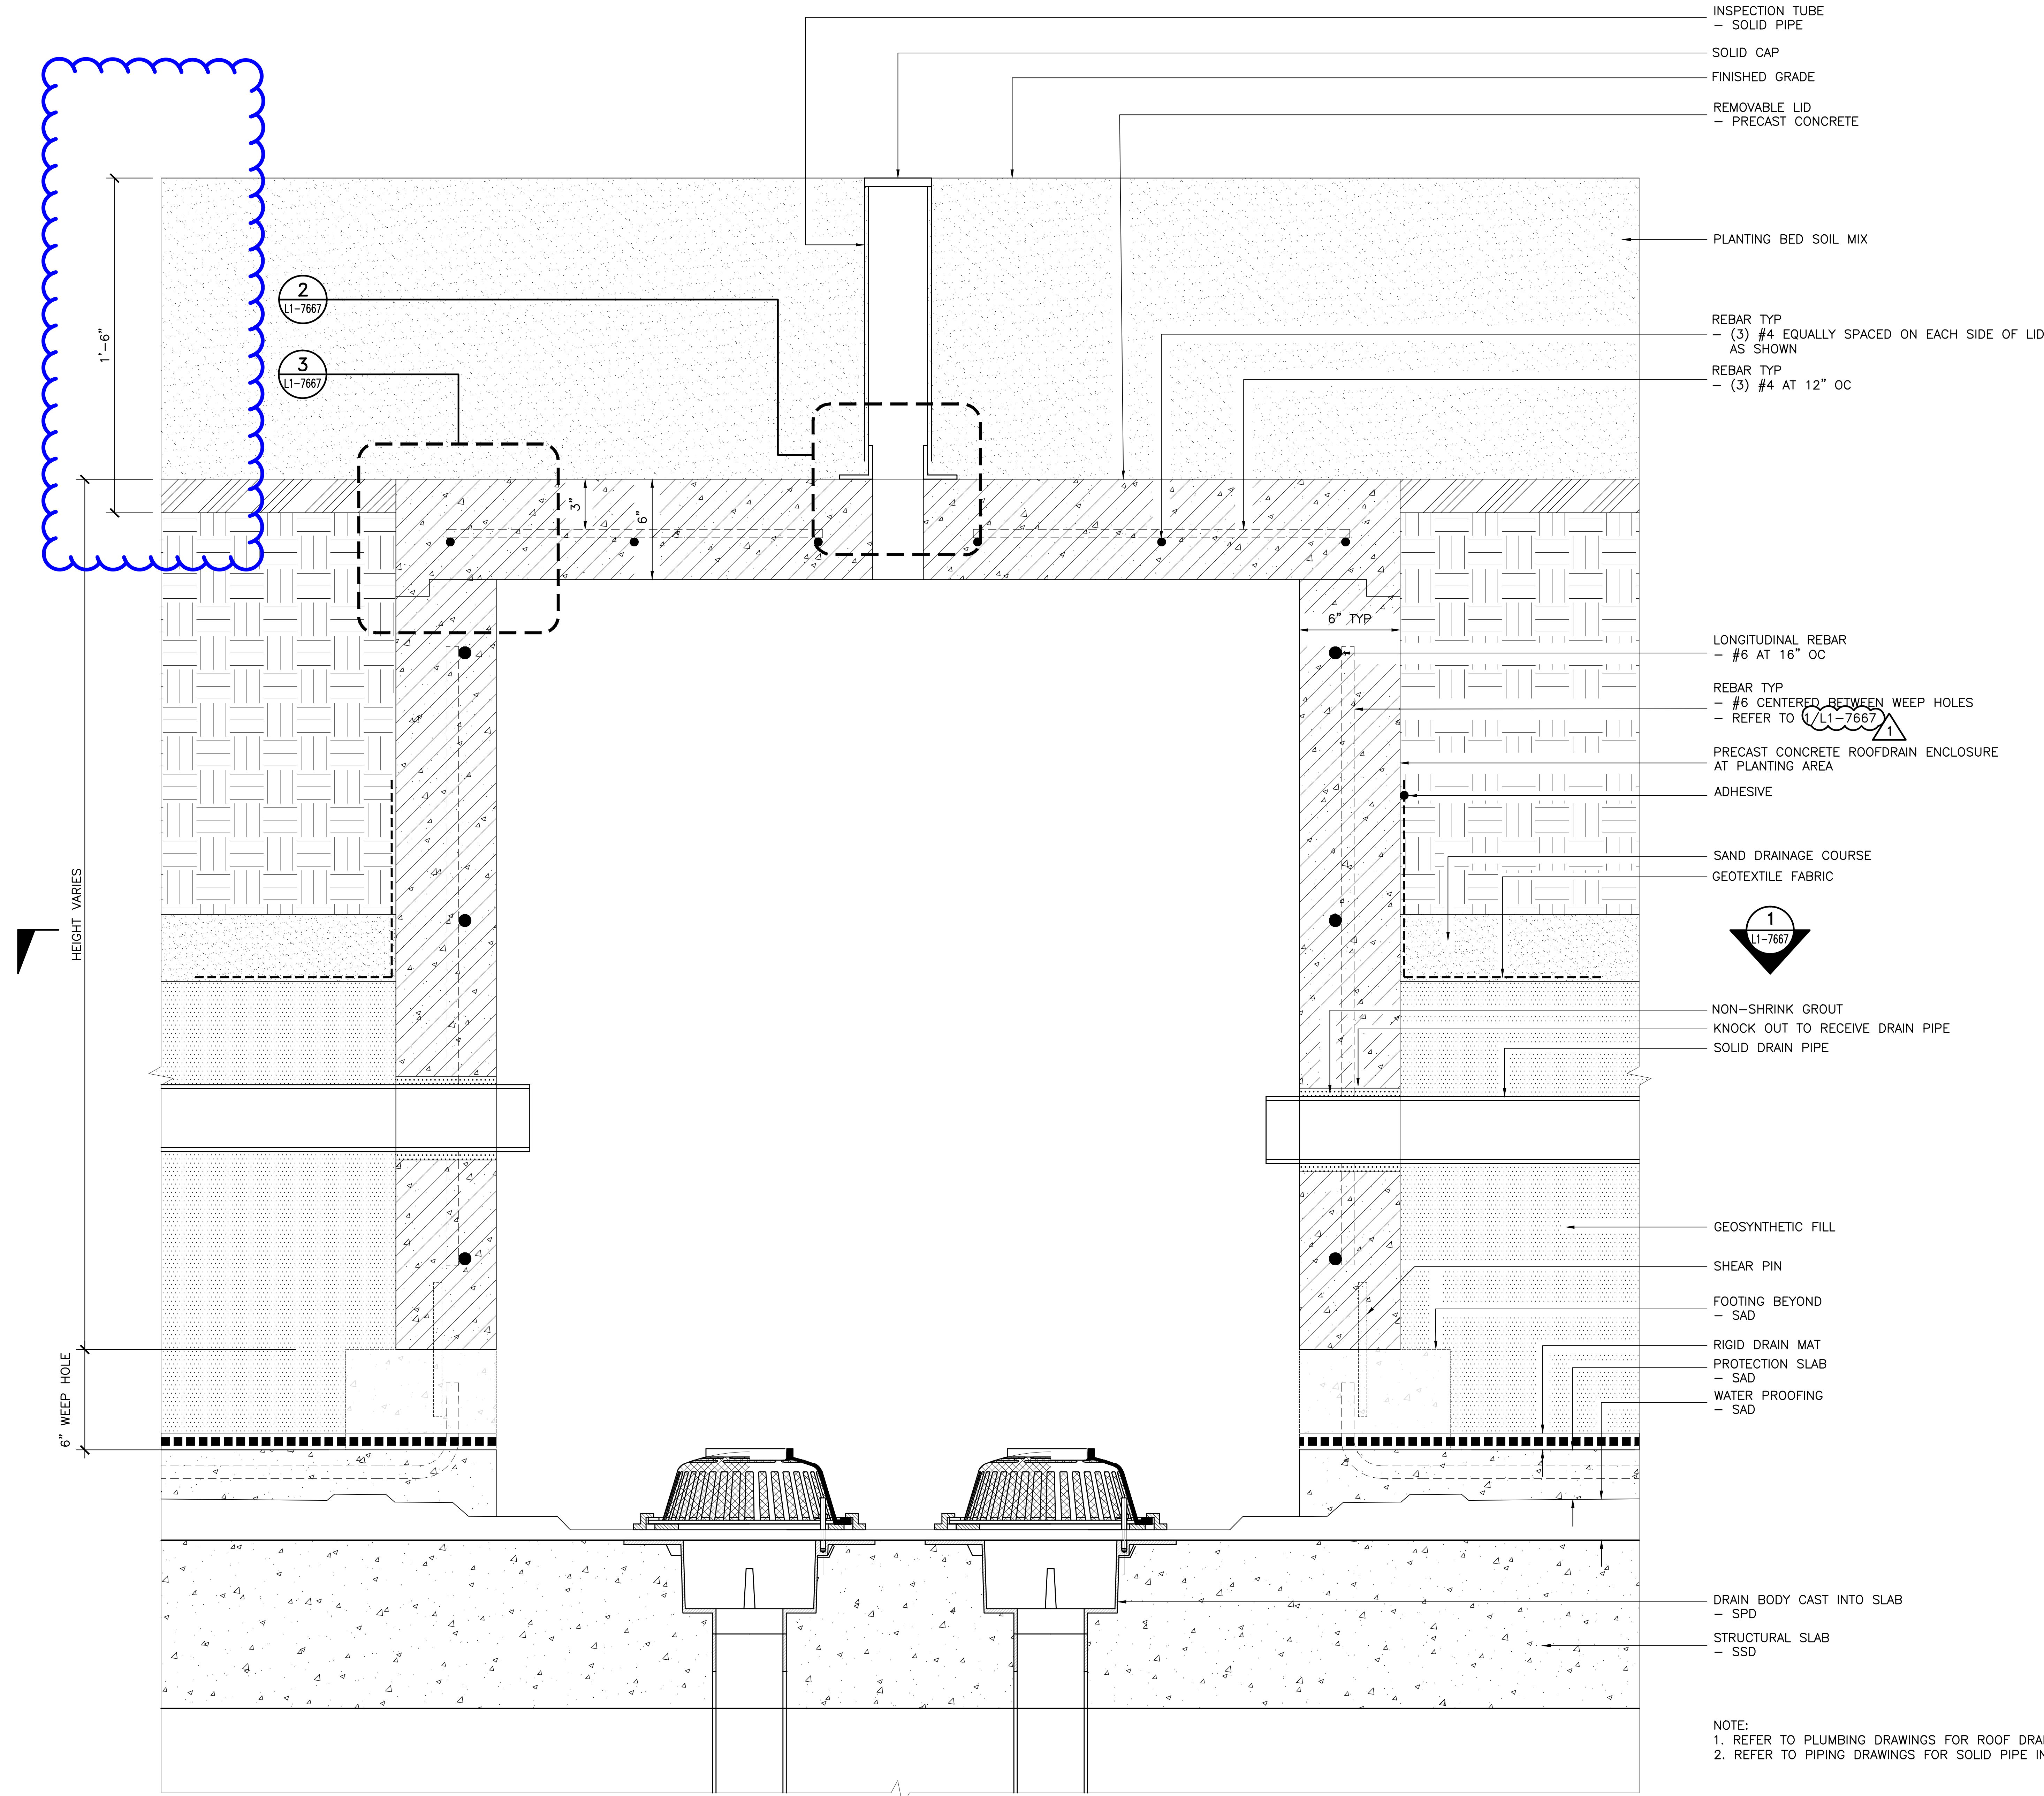


NOTE:
1. REFER TO PLUMBING DRAWINGS FOR ROOF DRAIN TYPE/LOCATION.
2. REFER TO PIPING DRAWINGS FOR SOLID PIPE INVERTS.

1 PRECAST CONCRETE ROOF DRAIN ENCLOSURE AT PLANTING AREA
LI-7665 SCALE: 3" = 1'

		08 04 CMCC 000	
PROJECT TITLE Transbay Transit Center		PROJECT NO. 08 04 CMCC 000	
DRAWING TITLE Response to RFI TG13.1-067		REVISIONS	
NO. DATE DESCRIPTION		01 12/16/14 FOR ASD NO. 0719	
DRAWING TITLE SKLA-401.0		DATE 04/30/15	
SCALE AS SHOWN		DRAWN BY: MG	
PROJECT NO.		CHECKED BY: CL	
LANDSCAPE ARCHITECTURE PARK LEVEL DETAILS PRECAST CONCRETE		Key Map	

Apr 30, 2015 3:16pm Z:\P\1801\Current\A\00\Plans\Layouts\L1-4603.dwg

Note: If this sheet is not 44" x 34", it has been revised from its original size. Scales noted on drawings/details are no longer applicable.

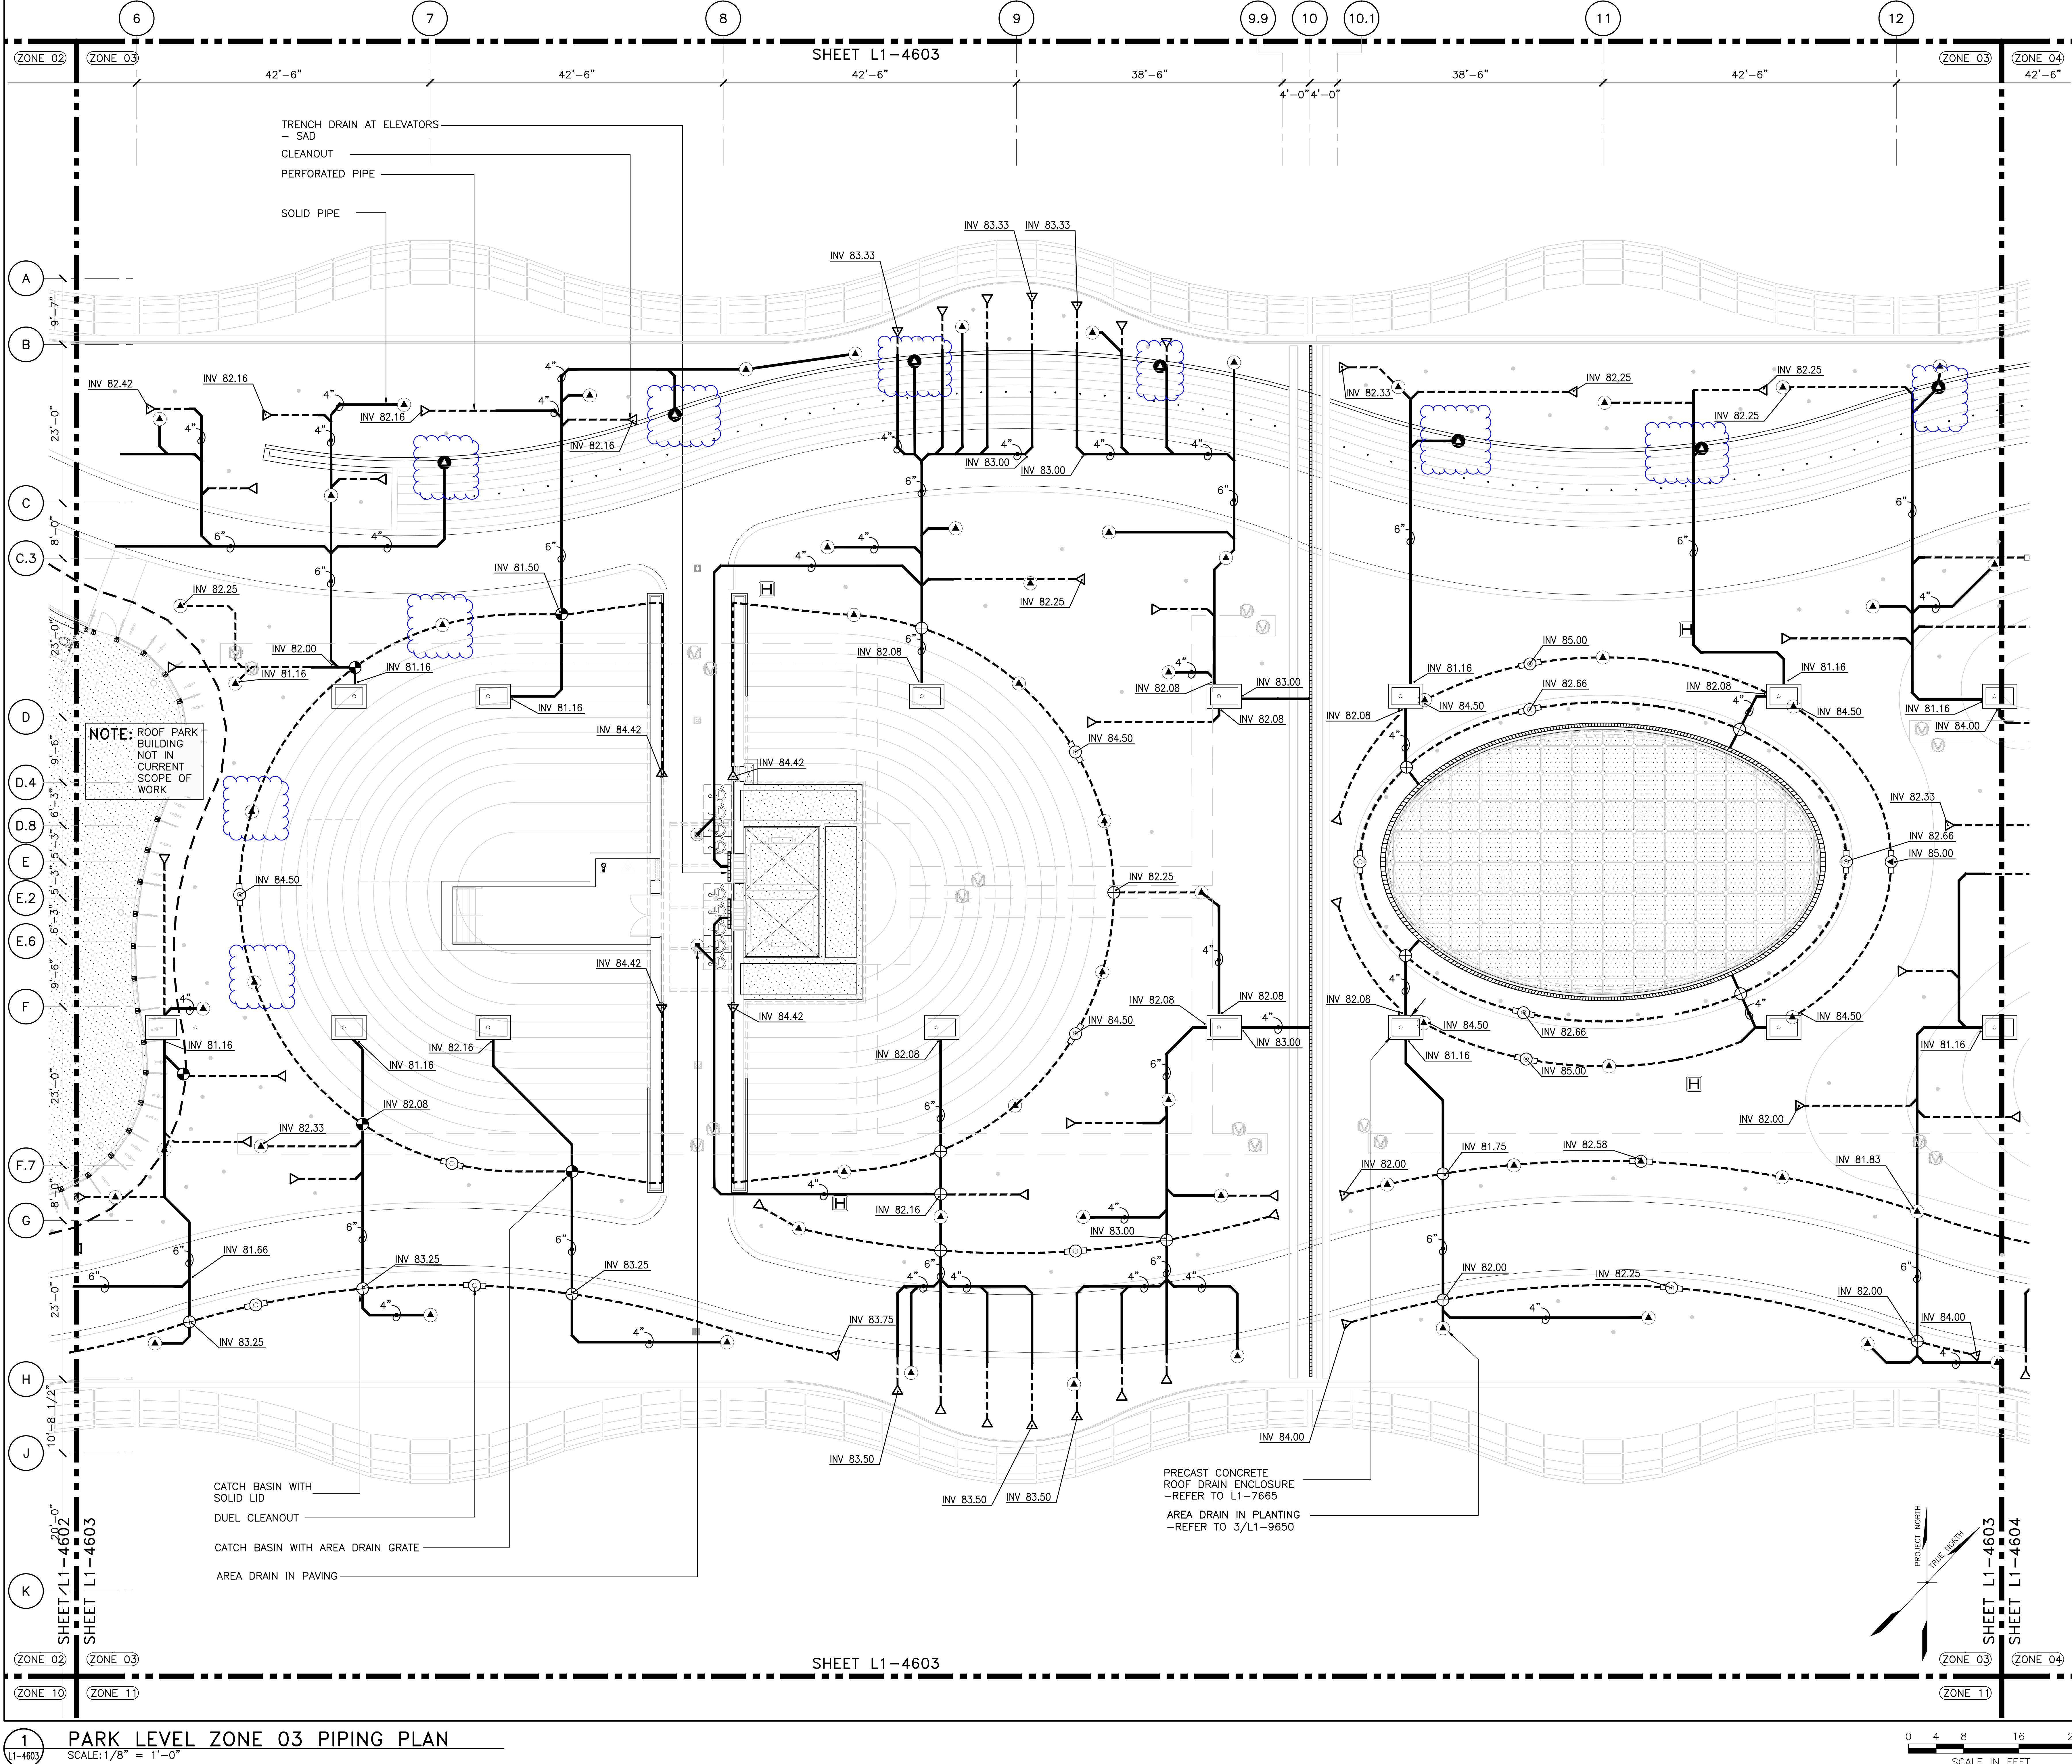

1 PARK LEVEL ZONE 03 PIPING PLAN
SCALE: 1/8" = 1'-0"

TRANSBAY TRANSIT CENTER
TRANSBAY TRANSIT CENTER
TRANSBAY TRANSIT CENTER

LANDSCAPE ARCHITECTURE
LANDSCAPE ARCHITECTURE
LANDSCAPE ARCHITECTURE

PHASE I
PHASE I
PHASE I

08-04-CMCC-000

SKLA-402.0

Response to RFI TG13.1-069

PROJECT TITLE: ISSUED FOR CONSTRUCTION
PROJECT NO. 0728

DATE: 04/30/15

SCALE: AS SHOWN

DRAWN BY: MG

CHECKED BY: CI

APPROVED: J. GANTER
APPROVED: J. GANTER
APPROVED: J. GANTER

PROJECT MANAGER: J. GANTER
PROJECT MANAGER: J. GANTER
PROJECT MANAGER: J. GANTER

DESIGNER: P. WALKER
DESIGNER: P. WALKER
DESIGNER: P. WALKER

DRAWN BY: B. COLLETT
DRAWN BY: B. COLLETT
DRAWN BY: B. COLLETT


SCALE: 1/8" = 1'-0"
SCALE: 1/8" = 1'-0"
SCALE: 1/8" = 1'-0"

SHEET NUMBER: 1
SHEET NUMBER: 1
SHEET NUMBER: 1

SEQUENCE NUMBER: 1
SEQUENCE NUMBER: 1
SEQUENCE NUMBER: 1

Note: If this sheet is not 44" x 34", it has been revised from its original size. Scales noted on drawings/details are no longer applicable.

Apr 30, 2015 3:25pm Z:\P\8\80\Current\ACAD\Drawings\Sheet\1-4604.dwg

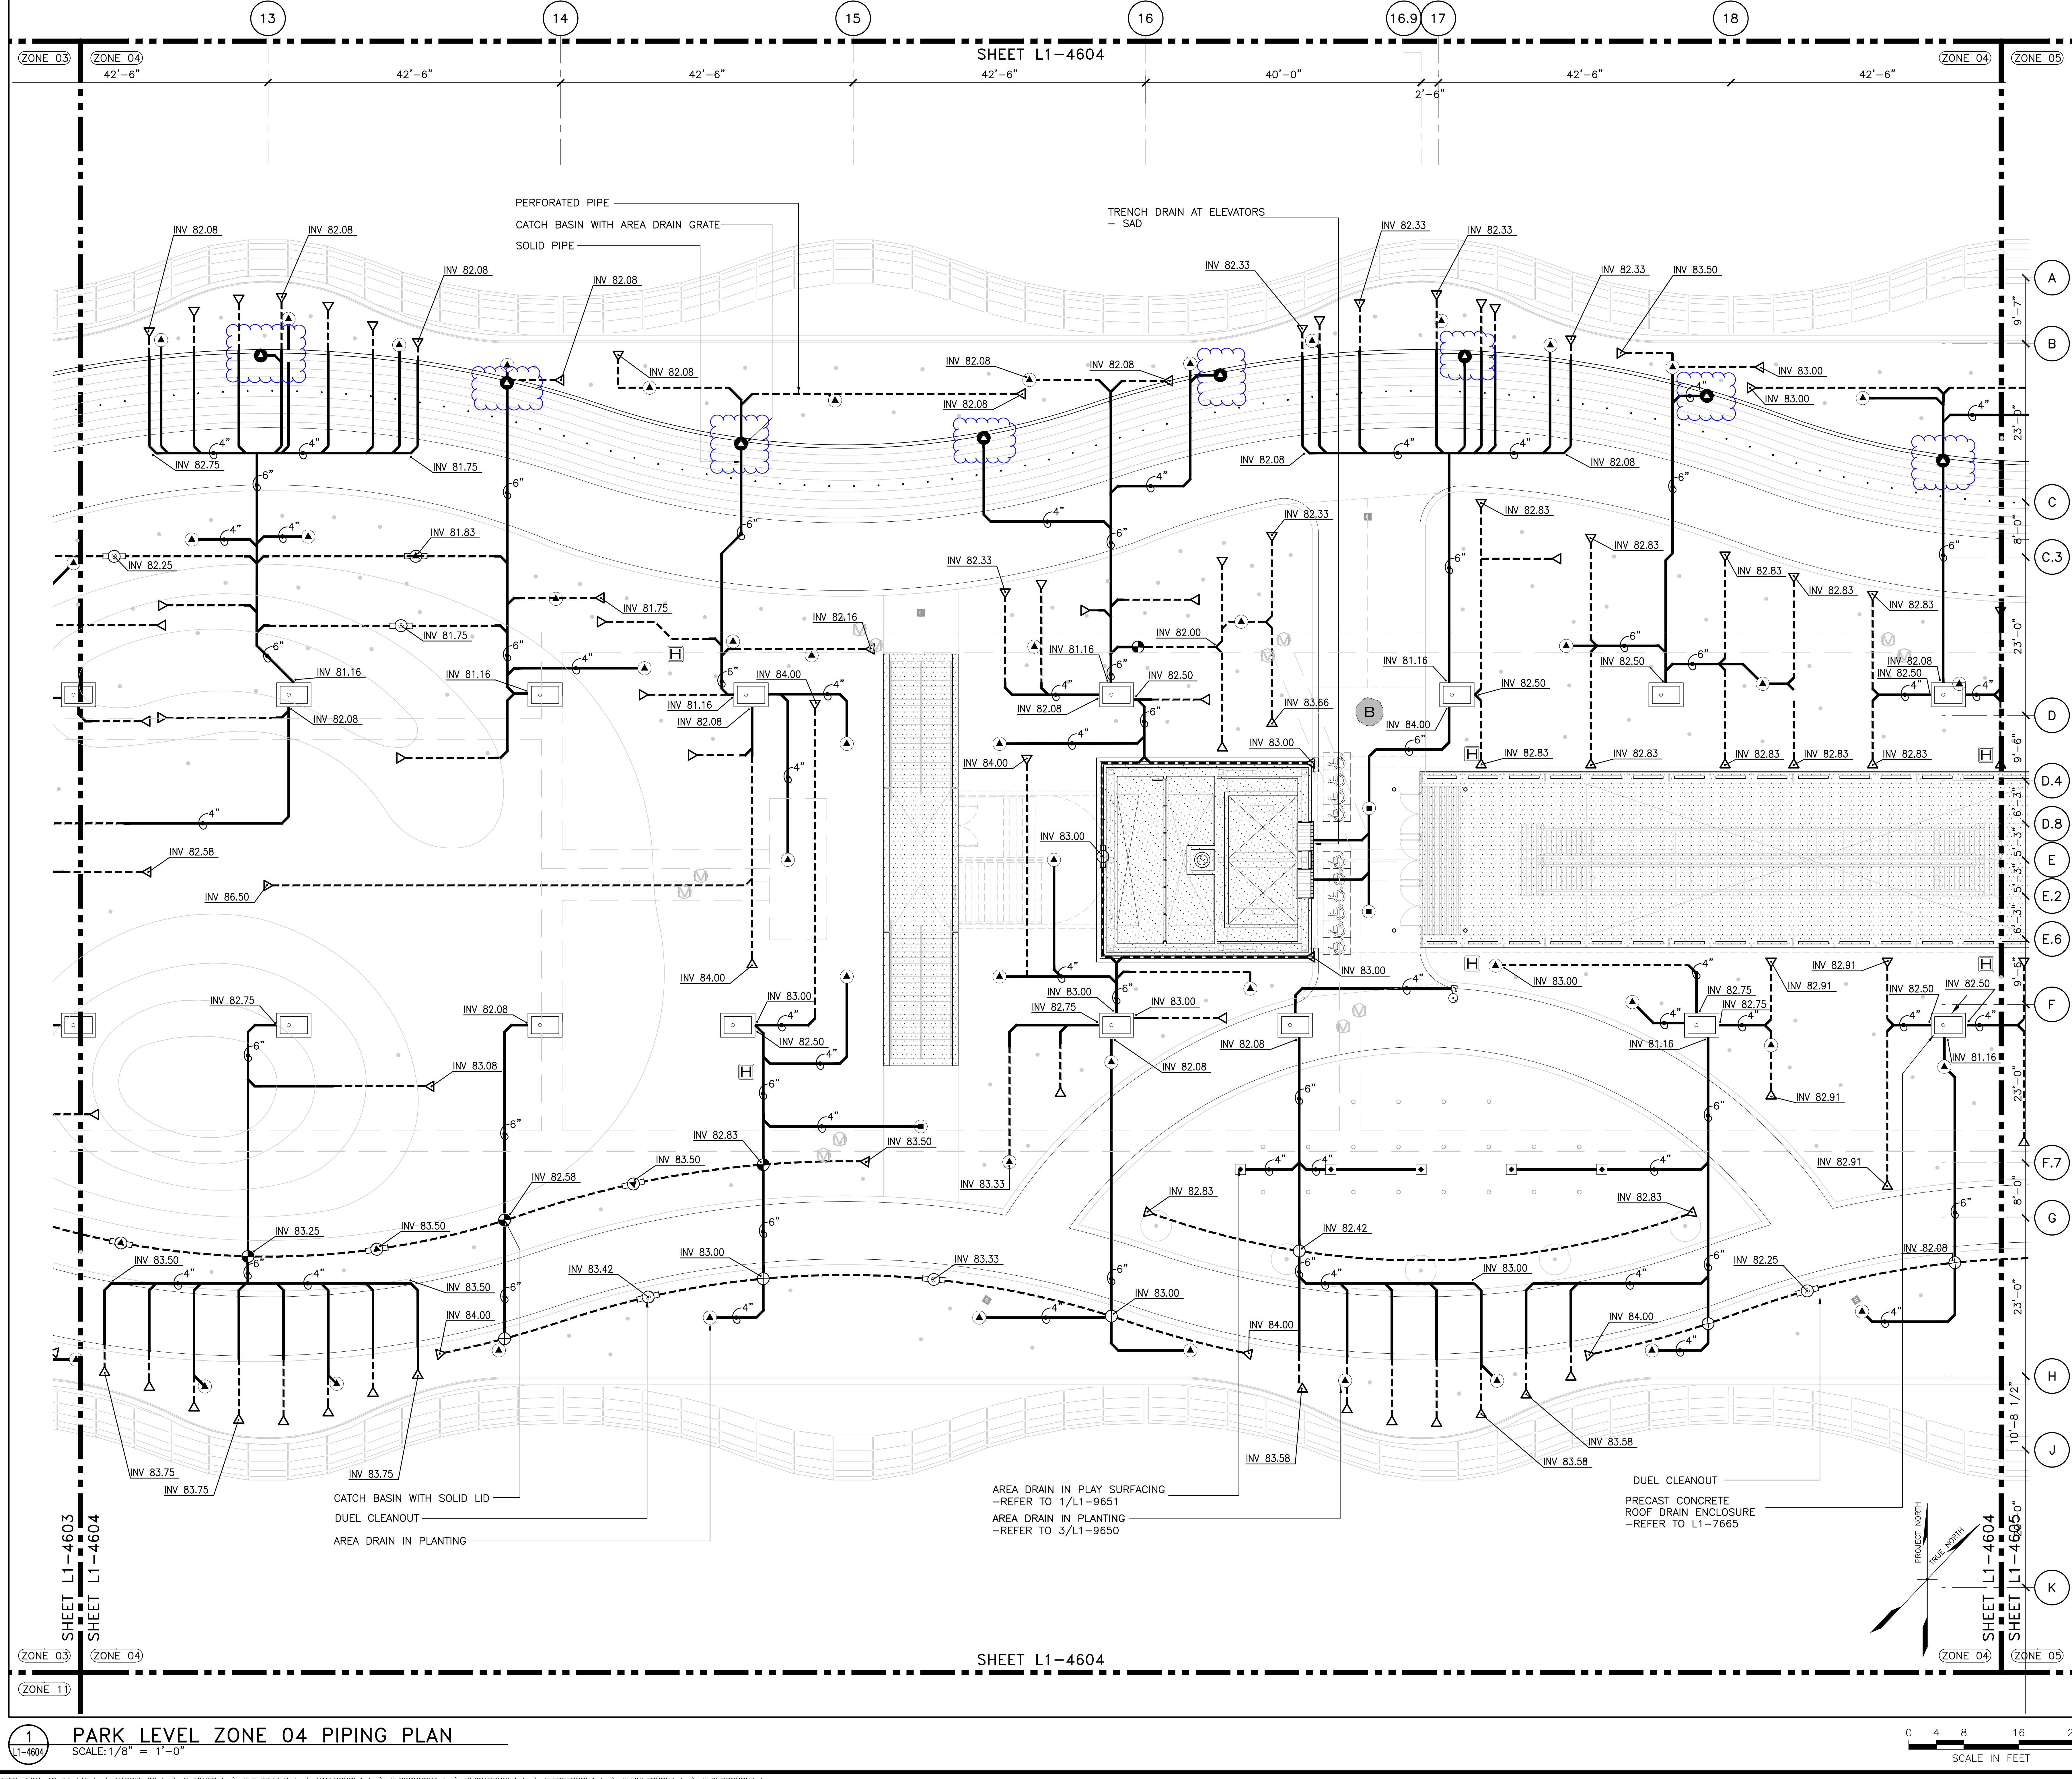

1 PARK LEVEL ZONE 04 PIPING PLAN
SCALE: 1/8" = 1'-0"

SKLA-402.1

Response to RFI TG13.1-069

DRAWING TITLE:

DRAWN BY: MG

CHECKED BY: CL

DATE: 04/30/15

SCALE: AS SHOWN

PROJECT NO.

PWP

LANDSCAPE ARCHITECTURE


Transbay Transit Center

L1-4604

of

Note: If this sheet is not 44" x 34", it has been revised from its original size. Scales noted on drawings/details are no longer applicable.

Apr. 30, 2015 3:29pm Z:\PDP\BAY\Current\A00\Phase\Layouts\L1-4605.dwg

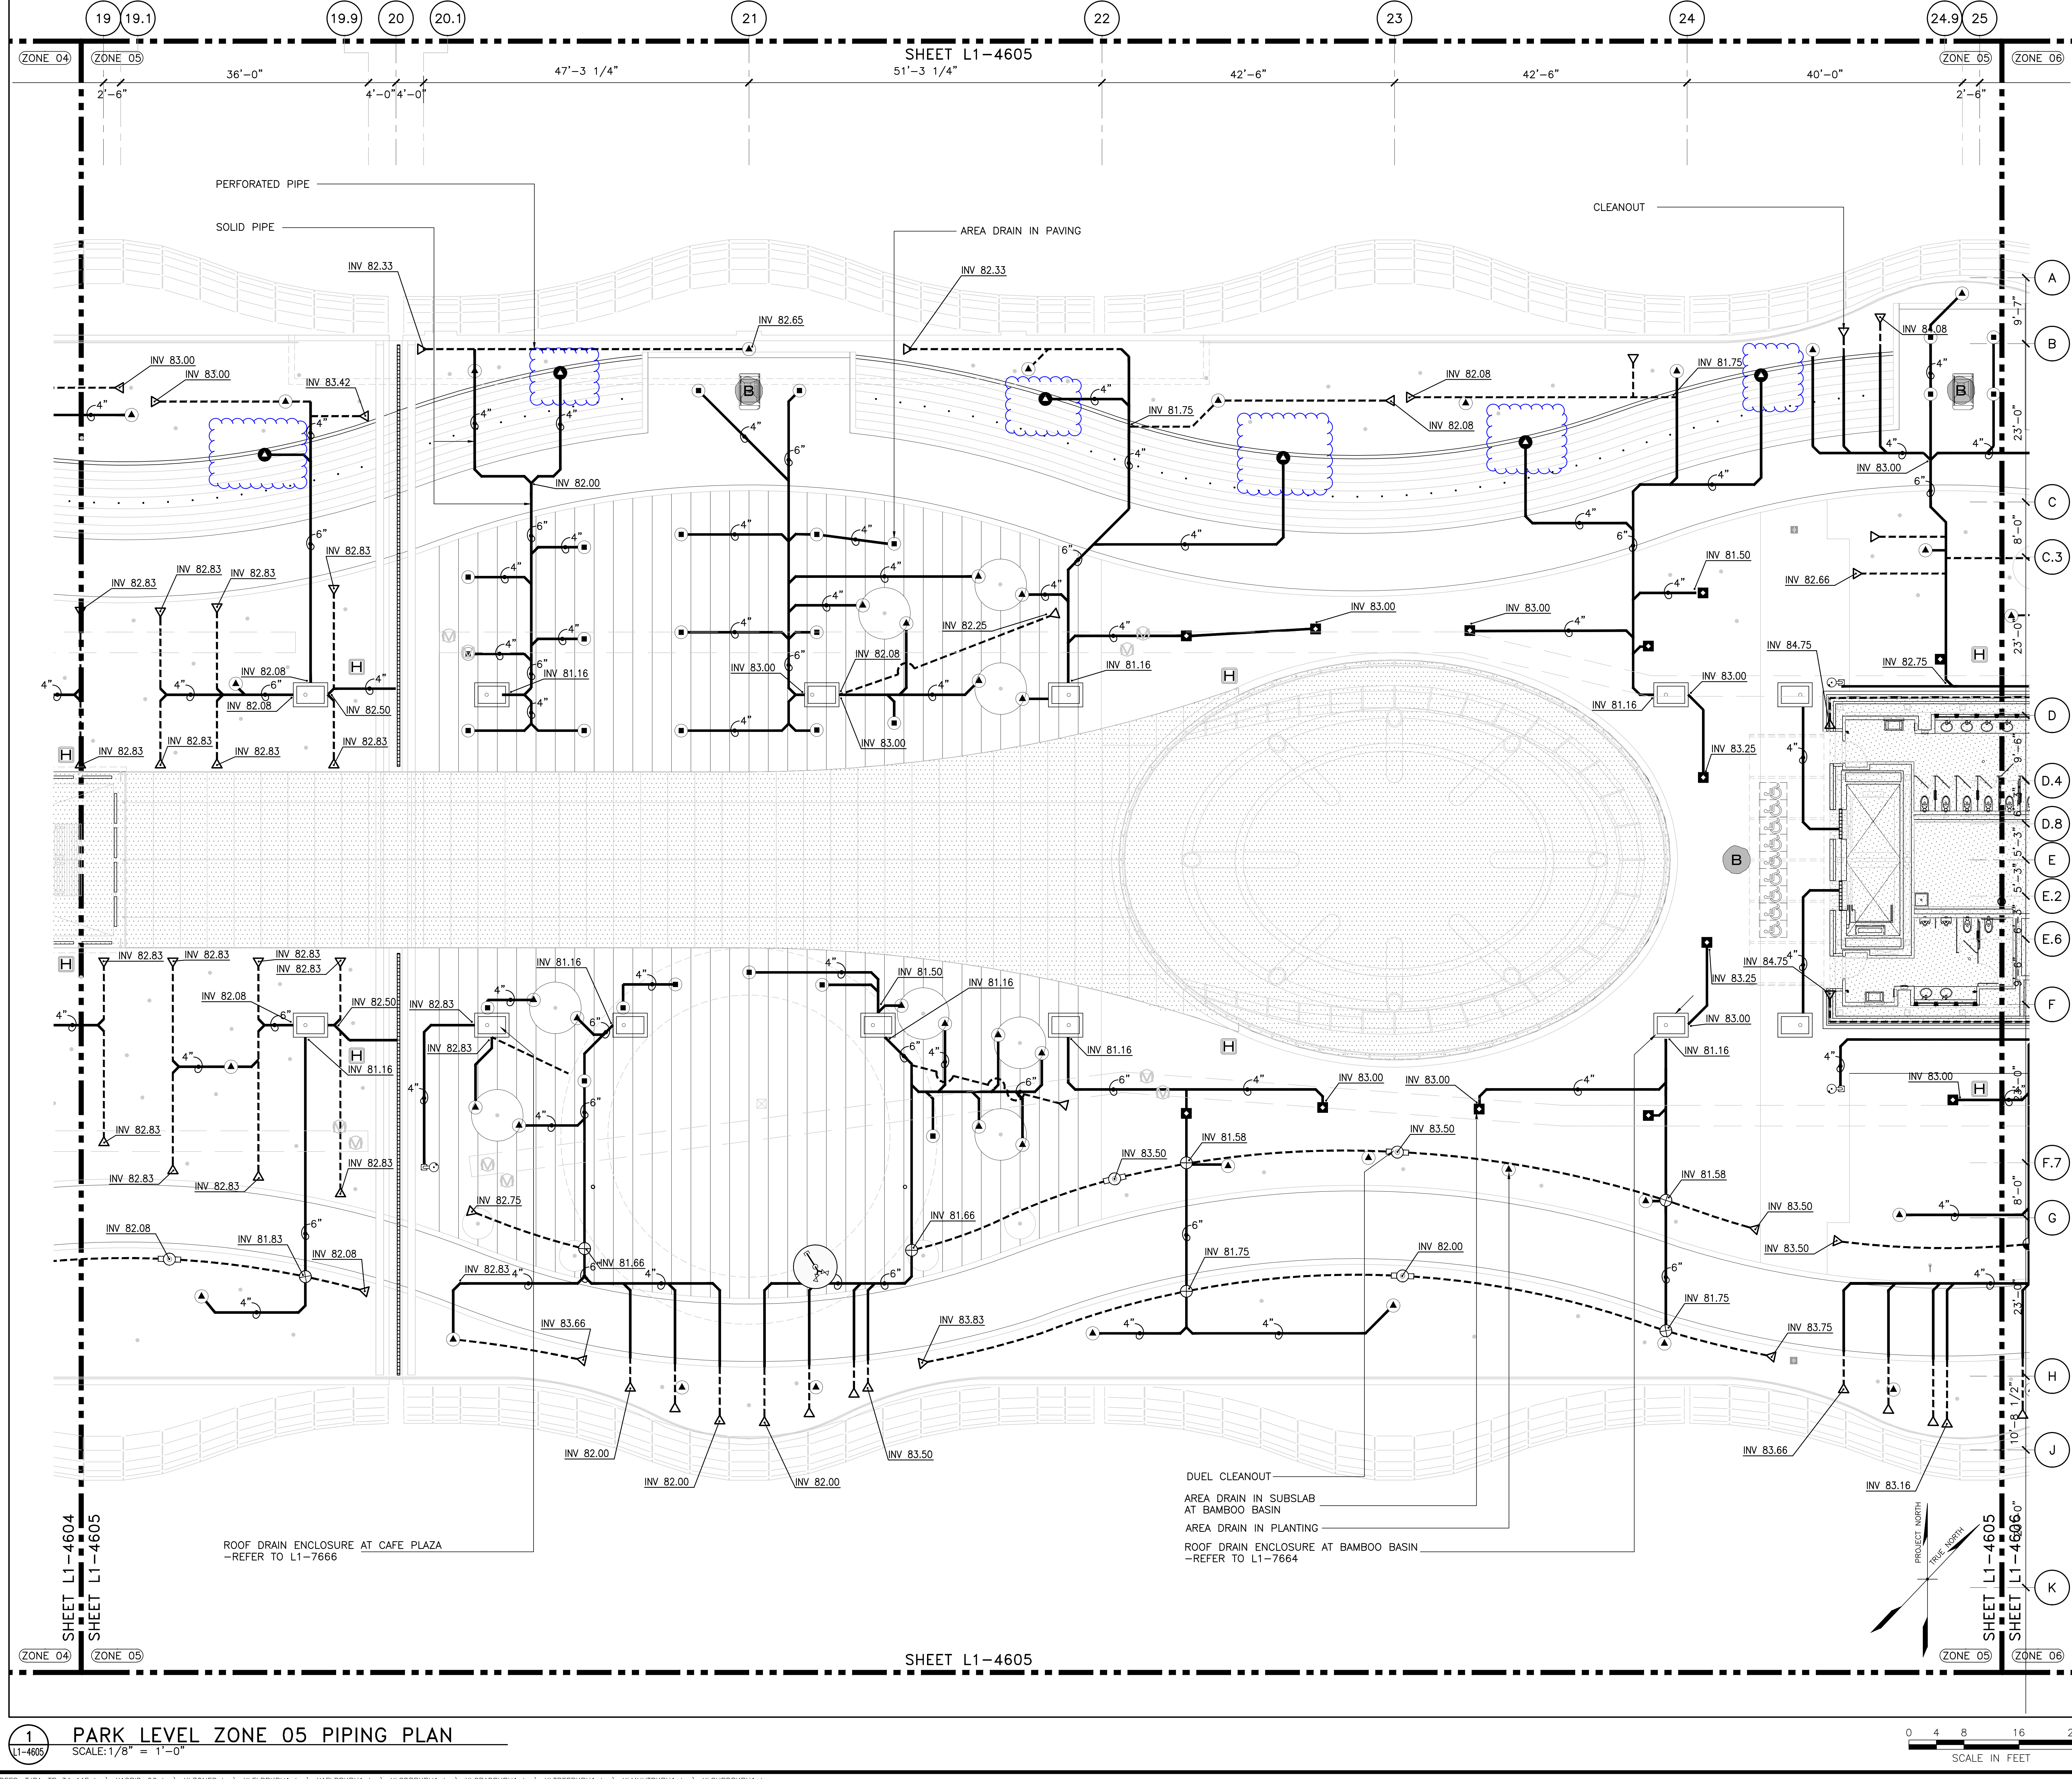

1 PARK LEVEL ZONE 05 PIPING PLAN
L1-4605 SCALE: 1/8" = 1'-0"

SKLA-402.2

Response to RFI TG13.1-069

DRAWING TITLE:

04/30/15

DATE:

AS SHOWN

SCALE:

MG

DRAWN BY:

CL

CHECKED BY:

PWP

LANDSCAPE ARCHITECTURE

Transbay Transit Center

L1-4605

of

SKLA-402.3

DRAWN BY: MG
CHECKED BY: CL

DRAWING TITLE:

DESCRIPTION	BY
03/17/14 ISSUED FOR CONSTRUCTION	DF
10/16/14 REVISED	DF

Response to RFI TG13.1-069

DATE: 04/30/15

SCALE: AS SHOWN
PROJECT NO.

PWP

LANDSCAPE ARCHITECTURE

ZONE 06 PIPING PLAN

Fireman's Fund Center

L1-4606

ISSUED FOR CONSTRUCTION

